


LABOR AND MATERIALS

1	Copper	} Connection ^{3/4}	\$
	Lead		
1	Curb	} Cock Valve T.S. & V.	\$
1	Service box	} Short 3 1/2 x 4 1/2 Long 4 1/2 x 5 1/2	\$
	Old returned		
22	1" in.	} NEW COPPER Copper G. I. Curb	\$
	Nipples	in. at	\$
1	Bushings	1 to 1/2 in. at	\$
	Red'g Inc'g	} Coupl'gs	to in. at \$
	Union	in. at	\$
	Meter	in. at	\$
			\$
	Compound Joints	at	\$
	Maintenance Foreman		\$
	Hrs. Water Maint. Man	—1 at	\$
	Hrs. Water Maint. Man	—2 at	\$
	Hrs. Garage Foreman	at	\$
	Hrs. Labor	at	\$
	Hrs. Compressor	at	\$
			\$
	Trucking		\$
	Pav't Patch		\$
			\$
			\$
			\$
			\$

CHESTER St. Pt. Ave. No. 31

Name of Owner

Labor and Mat'l. Report APR 19 25

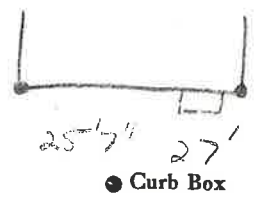

10" Main Elev. of Main at tap 4 1/2'

Gate at • Gate at •

• Curb Box

NEW COPPER 1" SERVICE
FROM MAIN TO CURB BOX
KH
7-30-2002