

LABOR AND MATERIALS


1	Copper	Connection	3/4"	\$	2.76
1	Lead				
1	Curb	Cock Valve	3/4 in.	\$	3.49
		T. S. & V.			
1	Service box	Short 3 1/2 X 4 1/2		\$	4.74
	Old returned	Long 4 1/2 X 5 1/2			
		Buff or Rdway			
11	Ft.	Copper	Pipe at 3/8	\$	4.18
		G. I.			
		C. I.			
	Nipples	in. at		\$	
	Bushings	to in. at		\$	
	Red'g				
	Inc'g	Coupl'gs to in. at		\$	
	Union	in. at		\$	
	Meter	in. at		\$	
	Lead Joints	at		\$	
	Compound Joints	at		\$	
	Hrs. Water Maint. Man-1	at		\$	
	Hrs. Water Maint. Man-2	at 1.24		\$	3.72
36	Hrs. Labor	at 1.13		\$	180.8
	Hrs. Labor	at		\$	
	Hrs. Compressor	at		\$	
	Compensation Ins.	at \$4.406 per C		\$	96
	Trucking			\$	1.00
	Pay't Patch			\$	9.00
	Tap made Nov 6 53				
	by Gifford				
	O'head			\$	
				\$	47.93

97 53

St. Chester
 Pt. 34
 Ave. No. 34

Name of Owner Geo Spaulding

Labor and Mat'l. Report Nov 5 1953

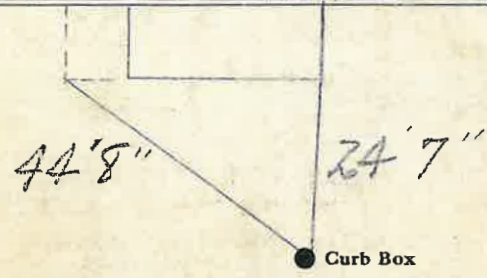

10" Main Elev. of Main at tap 5'

Gate at ● Gate at ●

TAX ID # 302.16-12-36

● Curb Box