


LABOR AND MATERIALS

1	Copper Lead	} Connection <u>3/4</u>	\$
1	Curb		} Cock Valve } <u>3/4 in.</u>
		T.S. & V.	
1	Service box Old returned	} Short <u>3 1/2</u> x <u>4 1/2</u> Long <u>4 1/2</u> x <u>5 1/2</u>	\$
28	Ft. <u>3/4</u> in.		} Copper C.I. C.I.
		} Pipe at	
	Nipples	in. at	\$
	Bushings	to in. at	\$
	Red'g } Inc'g }	} Coupl'gs to in. at	\$
	Union		in. at
	Meter	in. at	\$
			\$
	Compound Joints	at	\$
	Maintenance Foreman		\$
	Hrs. Water Maint. Man	1 at	\$
	Hrs. Water Maint. Man	2 at	\$
	Hrs. Garage Foreman	at	\$
	Hrs. Labor	at	\$
	Hrs. Compressor	at	\$
			\$
	Trucking		\$
	Pav't Patch		\$
			\$
			\$
CHESTER St. 9
~~Pl.~~
 Ave. No. 9

Name of Owner _____
 Labor and Mat'l. Report OCT. 1934

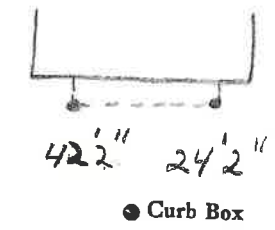

10" Main Elev. of Main at tap 5'
 Gate at • Gate at •

* H₂O SERVICE LOOPS AROUND
NEW MAN HOLE ON WEST SIDE.
 KH