

LABOR AND MATERIALS


1 Copper Lead } Connection $3/4"$ \$
 1 Curb Valve } $3/4$ in. (MAY 11) (ORISEAL) \$
 T.S. & V. }
 1 Service box { Short $3\frac{1}{2} \times 4\frac{1}{2}$ } \$
 Old returned { Long $4\frac{1}{2} \times 5\frac{1}{2}$ } \$
 { Buff or Rdway } \$
 38 Ft. $3/4$ in. { Copper } Pipe at \$
 { G. I. }
 { C. I. }
 Nipples in. at \$
 Bushings to in. at \$
 Red'g } Coupl'gs. to in. at \$
 Inc'g }
 Union in. at \$
 Meter in. at \$
 Lead Joints at \$
 Compound Joints at \$
 Maintenance Foreman \$
 Hrs. Water Maint. Man-1 at \$
 Hrs. Water Maint. Man-2 at \$
 Hrs. Garage Foreman at \$
 Hrs. Labor at \$
 Hrs. Compressor at \$
 Compensation Ins. at \$ per C \$
 Trucking \$
 Pav't Patch \$
 TAP MADE BY GIFFORD \$
 NOV-12-1973 \$
 O'head \$

Church

St. Pt. Ave. No. ?

Name of Owner
 SASELLI ASSOCIATES

Labor and Mat'l. Report Nov 12 1973

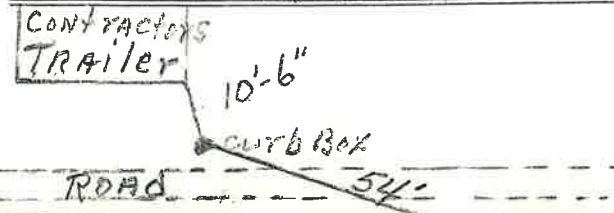

6" Main Elev. of Main at tap 5'

Gate at • Gate at •
 • Curb Box

TEMPORARY TAP