



Measure from 16

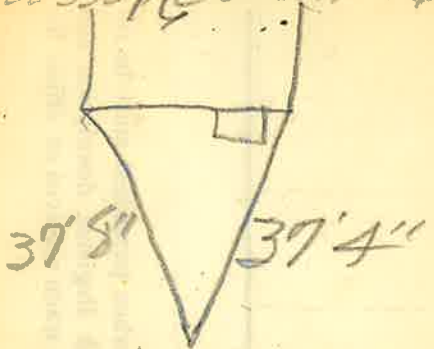

Old Buffalo Br
Church ST
Measure from
16 across the
Street

20 Church
Measure from 20
across the ST

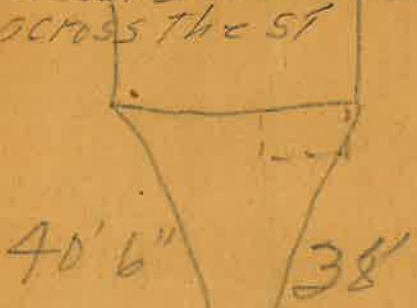

Curb box removed from
^{side walk}
Measure from 16
across the ST.



Repaired Curb box
from side walk