

Labor and Materials


Copper } Connection.....	2	\$ 2.60
Lead }		
Curb } Cock Valve }	1	\$ 2.30
T.S. & V. }		
Service Box } Short 3/4 x 4 1/2 }	1	\$ 1.40
Old returned } Long 4 x 5 1/2 }		
	Buff. or Rdway }	
15 Ft. in. } Copper } Pipe at.....	3/4	\$ 3.98
	Cast Iron }	
Nipples..... in. at.....		\$
Bushings..... to..... in. at.....		\$
Red'g } Couplings..... to..... in. at.....		\$
Inc'g }		
Union..... in. at.....		\$
Meter..... in. at.....		\$
Lbs. Br. Stone at.....		\$
Lbs. Sand at.....		\$
Bags Cement 'at.....		\$
Paving Brick } Mack } at.....		\$
	Red }	
	Asphalt }	
Lead Joints at.....		\$
Leadite Joints at.....		\$
3 Hrs. Foreman at.....		\$ 1.88
16 Hrs. Common Labor at.....		\$ 6.50
Hrs. Common Labor at.....		\$
Hrs. Mason at.....		\$
Hrs. Mason's Helper at.....		\$
Hrs. Compressor at.....		\$
Compensation Ins.....		\$ 22
Trucking.....		\$ 1.00
Builders' Use of Water Patch.....		\$ 5.00
Total \$ 24.88		

29-112

Labor and Material Report

15 1929

18 Church St

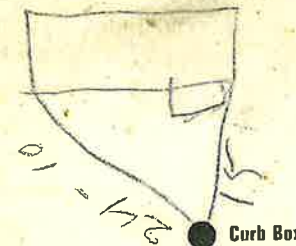

4 Main Elev of Main at tap

Gate at ● ● Gate at

● Curb Box

Add Tap Shut off at main

RAZED