

1.1 8-1937


Church

St. Pt. Ave. No. 5

Name of Owner

ST Mary Sister Home

Labor and Mat'l. Report Sept 16 1937

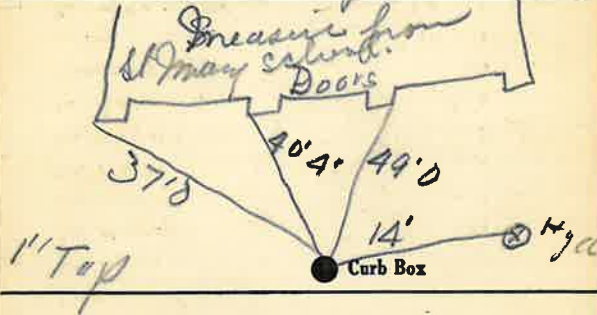

4 Main

Elev. of Main at tap 42

Gate at

Gate at

Curb Box

at Street

Shut off at Main

This Building Razed July 6-46

WATER DEPARTMENT

City of Glens Falls, New York

Sept 13 1937

A. M. P. M.


M. D. Dugan 1" Tap

Tel. Call: V. Church St

Turn on: Sister Home

Shut off:

Leak:

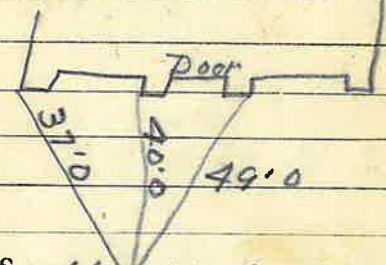

Misc.

REMARKS: old shut off

4" Main 4 1/2 ft Deep

9 ft of 1" Copper pipe

Tap made Sept 13-37

by Humel

By: [Signature] From: Office To: 13, ^

