

### LABOR AND MATERIALS

1	Copper	{ Connection	3/4		\$ 2.27
	Lead				
1	Curb	{ Cock Valve F.S. & V. }	3/4 in.		\$ 3.70
1	Service box	{ Short 3 1/2 x 4 1/2 Long 4 1/2 x 5 1/2 Buff or Rdway }			\$ 4.25
	Old returned				
27	Ft. 3/4 in.		Copper	Pipe at 35	
		G.I.			
		G.I.			
	Nipples	in. at			\$
	Bushings	to in. at			\$
	Red'g	{ Coupl'gs to in. at			\$
	Ino'g				
	Union	in. at			\$
	Meter	in. at			\$
	Lead Joints at				\$
	Compound Joints at				\$
	Hrs. Water Maint. Man-1 at				\$
3	Hrs. Water Maint. Man-2 at	1.02			\$ 3.06
14	Hrs. Labor—	at 91			\$ 12.74
	Hrs. Labor—	at			\$
	Hrs. Compressor at				\$
	Compensation Ins. at \$2.226 per C.				\$ 3.5
	Trucking				\$ 1.00
	Pav't Patch				\$
	Tap by Moquin				\$
					\$
					\$
	O'head				\$
					\$ 35.93

217-1900

Clayton

Avena


St. \_\_\_\_\_  
Pl. \_\_\_\_\_  
Ave. No. 24

Name of Owner

Donald Cameron.

Labor and Mat'l. Report

Oct. 24 19 50

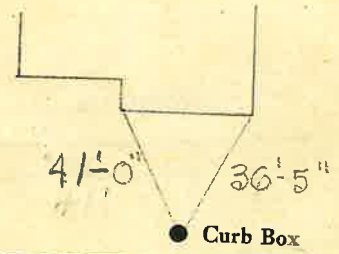

6" Main

Elev. of Main at tap 5'

Gate at ●

● Gate at

● Curb Box