

LABOR AND MATERIALS


Copper	} Connection	_____	\$	_____	
Lead		_____	\$	_____	
Curb	} Cock Valve T. S. & V.	_____ in.	\$	_____	
Service box		} Short 3½ x 4½ Long 4½ x 5½	_____	\$	_____
Old returned			_____	\$	_____
Ft. _____ in.	} Copper G. I. C. I.	Pipe at _____	\$	_____	
Nipples _____ in.		at _____	\$	_____	
Bushings _____ to _____ in.		at _____	\$	_____	
Red'g } Inc'g }	} Coupl'gs	_____ to _____ in.	\$	_____	
Union _____ in.		at _____	\$	_____	
Meter _____ in.	at _____	\$	_____		
_____			\$	_____	
Compound Joints	at _____	\$	_____		
Maintenance Foreman	_____	\$	_____		
Hrs. Water Maint. Man—1	at _____	\$	_____		
Hrs. Water Maint. Man—2	at _____	\$	_____		
Hrs. Garage Foreman	at _____	\$	_____		
Hrs. Labor—	at _____	\$	_____		
Hrs. Compressor	at _____	\$	_____		
_____			\$	_____	
Trucking	_____	\$	_____		
Pav't Patch	_____	\$	_____		
_____			\$	_____	
_____			\$	_____	
St. REAR
Pl. _____
Ave. No. 20-22R

CLENDON

Name of Owner _____

Labor and Mat'l. Report OCT. 19 33

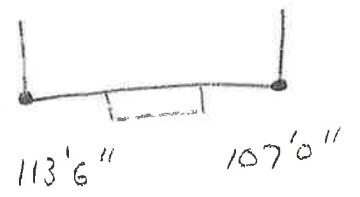

● Curb Box

Main	Elev. of Main at tap _____
Gate at ●	● Gate at

● Curb Box

THIS HOUSE IS IN REAR
OF #20 + #22