

LABOR AND MATERIALS

1	Copper	{	Connection	3/4"	\$	229
	Lead					
1	Curb	{	Cock Valve	3/4" in.	\$	270
			F.S. & V.			
1	Service box	{	Short	3 1/2 x 4 1/2	\$	425
	Old returned		Long	4 1/2 x 5 1/2		
			Buff or Rdway			
470	Ft.	3/4 in.	{	Copper	Pipe at	35 \$1470
				G.I.		
				G.I.		
	Nipples	in. at			\$	
1	Bushings	3/4 to 1/2 in. at			\$	10
	Red'g	{	Coupl'gs	to in. at	\$	
	Inc'g					
	Union	in. at			\$	
	Meter	in. at			\$	
	Lead Joints at				\$	
	Compound Joints at				\$	
	Hrs. Water Maint. Man—1 at				\$	
	Hrs. Water Maint. Man—2 at				\$	
	Hrs. Labor—	at			\$	
	Hrs. Labor—	at			\$	
	Hrs. Compressor at				\$	
	Compensation Ins. at \$	per C.			\$	
	Trucking				\$	1.00
	Pay't Patch				\$	
	Tap by Maquin				\$	
					\$	
					\$	
	O'head				\$	
					\$	

leak in service.
New service made

11-1950 To Be Billed


St. Clendon
Ave. No. 2020

Name of Owner

Joseph G. Andrus.

Labor and Mat'l. Report

Aug 4 19 50

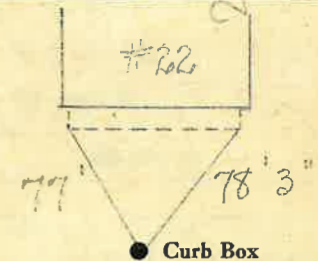

6" Main Elev. of Main at tap 8'

Gate at ●

● Gate at

TAX ID # 309.36-3-1

● Curb Box

Tap on Main is between 6" Gate & 6" x 6" x 6" Tee about 15" North of 6" Gate

Tap on Main is between 6" Gate and 6" x 6" x 6"
Tee about 15" North of 6" Gate