

LABOR AND MATERIALS

1	Copper	} Connection	$\frac{3}{4}$		\$
	Lead				
1	Curb	} Cock	$\frac{3}{4}$ in.		\$
		} Valve			
		} T.S. & V.			
	Service box	{ Short $3\frac{1}{2}$ x $4\frac{1}{2}$			\$
	Old returned	{ Long $4\frac{1}{2}$ x $5\frac{1}{2}$			
		{ Buff or Rdway			
22	- Ft	{ Copper		Pipe at	\$
	$\frac{3}{4}$ in.	{ C.I.			
		{ C.I.			
	Nipples	in. at			\$
	Bushings	to in. at			\$
	Red'g				\$
	Inc'g	Coupl'gs to in. at			\$
	Union	in. at			\$
	Meter	in. at			\$
	Lead Joints at				\$
	Compound Joints at				\$
	Maintenance Foreman				\$
	Hrs. Water Maint. Man-1 at				\$
	Hrs. Water Maint. Man-2 at				\$
	Hrs. Garage Foreman at				\$
	Hrs. Labor at				\$
	Hrs. Compressor at				\$
	Compensation Ins. at \$	per C.			\$
	Trucking				\$
	Pav't Patch				\$
					\$
					\$
	O'head				\$
					\$


CLINTON

St. _____
Pl. _____
Ave. No. 9

Name of Owner

Labor and Mat'l. Report

19

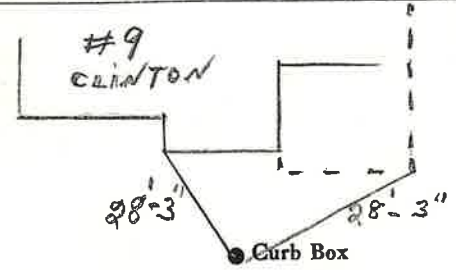

Main _____ Elev. of Main at tap _____

Gate at • _____ Gate at _____

• Curb Box

This Tap on School St.