


LABOR AND MATERIALS

1	Copper	} Connection <sup>3/4</sup>	_____	\$ _____
1	Lead			
1	Curb	} Cock Valve T.S. & V. } <sup>3/4</sup> in.	_____	\$ _____
1	Service box			
Old returned	{ Short <sup>3 1/2</sup> x <sup>4 1/2</sup> } { Long <sup>4 1/2</sup> x <sup>5 1/2</sup> }			
12	Ft. <sup>3/4</sup> in.	{ Copper } { <del>C.I.</del> } { <del>C.I.</del> }	Pipe at _____	\$ _____
	Nipples	_____ in. at _____		\$ _____
	Bushings	_____ to _____ in. at _____		\$ _____
	Red'g } Inc'g }	Coupl'gs _____ to _____ in. at _____		\$ _____
	Union	_____ in. at _____		\$ _____
	Meter	_____ in. at _____		\$ _____
	Compound Joints	at _____		\$ _____
	Maintenance Foreman			\$ _____
	Hrs. Water Maint. Man-1	at _____		\$ _____
	Hrs. Water Maint. Man-2	at _____		\$ _____
	Hrs. Garage Foreman	at _____		\$ _____
	Hrs. Labor	at _____		\$ _____
	Hrs. Compressor	at _____		\$ _____
	Trucking			\$ _____
	Pav't Patch			\$ _____
				\$ _____
				\$ _____
COOLIDGE ~~St.~~ ~~Pl.~~ Ave. No. 11  
 Name of Owner FLORENCE B. SEELYE  
 Labor and Mat'l. Report JULY 1 1937

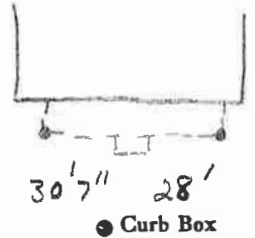

6" Main Elev. of Main at tap 5'  
 Gate at • Gate at •

TAX ID # 302.15-7-19

• Curb Box

OLD SHUT OFF