


OUTSIDE CLEAN OUT

LSM-5C-6-1-67

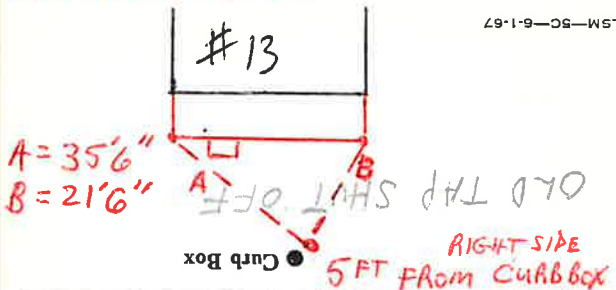


Gate at ● Gate at

Main at tap ● Main at tap

Elev. of Main at tap 4/2'

Main 6"

● Curb Box

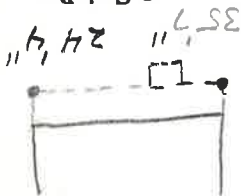

Labor and Mat'l. Report JUNE 23 1928

Name of Owner

COOLIDGE Ave. No. 13


COOLIDGE

St. Ave. No. 13

Name of Owner

Labor and Mat'l. Report

JUNE 23 1928

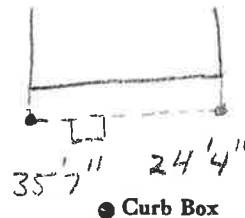

Main 6"

Elev. of Main at tap 4/2'


Gate at ●

● Gate at

TAX ID # 302.15-7-18

RIGHT SIDE 5 FT FROM CURBBOX ● Curb Box

OLD TAP SHUT OFF

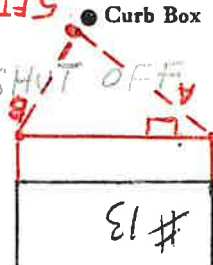

OUTSIDE CLEAN OUT

LSM-5C-6-1-67

