


LABOR AND MATERIALS

1	Copper	} Connection	3/4	_____	\$ _____
	Lead				
1	Curb	} Cook Valve T.S. & V.	} 3/4 in.	_____	\$ _____
1	Service box	} Short 3 1/2 x 4 1/2	}	_____	\$ _____
	Old returned				
33	Ft.	} Copper	} 3/4 in.	} Pipe at _____	\$ _____
	Nipples	_____ in.	at _____	\$ _____	
	Bushings	_____ to _____	in. at _____	\$ _____	
	Red'g	} Coupl'gs	} _____ to _____	} in. at _____	\$ _____
	Inc'g				
	Union	_____ in.	at _____	\$ _____	
	Meter	_____ in.	at _____	\$ _____	
	Compound Joints	at _____	\$ _____		
	Maintenance Foreman	_____	\$ _____		
	Hrs. Water Maint. Man-1	at _____	\$ _____		
	Hrs. Water Maint. Man-2	at _____	\$ _____		
	Hrs. Garage Foreman	at _____	\$ _____		
	Hrs. Labor	_____ at _____	\$ _____		
	Hrs. Compressor	at _____	\$ _____		
	Trucking	_____	\$ _____		
	Pav't Patch	_____	\$ _____		
			\$ _____		
			\$ _____		
COOLIDGE St. Pt. Ave. No. 26

Name of Owner  
BERTHA WILMARTH

Labor and Mat'l. Report 6-27 1937

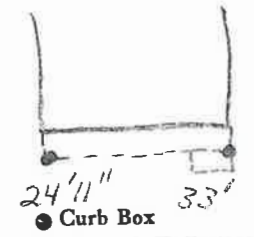

6" Main Elev. of Main at tap 5'

Gate at ● ● Gate at

TAX ID # 302.15-12-18

● Curb Box

OLD SHUT OFF