


LABOR AND MATERIALS

1	Copper	} Connection	3/4	_____	\$ _____	
	Lead					
1	Curb	} Cock Valve T.S. & V.	} 3/4 in.	_____	\$ _____	
1	Service box	} Short 3 1/2 x 4 1/2	}	_____	\$ _____	
	Old returned					Long 4 1/2 x 5 1/2
10	Ft. 3/4 in.	} Copper	}	Pipe at _____	\$ _____	
						G.I.
						G.I.
	Nipples	in. at _____			\$ _____	
	Bushings	to _____ in. at _____			\$ _____	
	Red'g Inc'g	} Coupl'gs	to _____ in. at _____	_____	\$ _____	
	Union	in. at _____			\$ _____	
	Meter	in. at _____			\$ _____	
					\$ _____	
	Compound Joints	at _____			\$ _____	
	Maintenance Foreman				\$ _____	
	Hrs. Water Maint. Man-1	at _____			\$ _____	
	Hrs. Water Maint. Man-2	at _____			\$ _____	
	Hrs. Garage Foreman	at _____			\$ _____	
	Hrs. Labor-	at _____			\$ _____	
	Hrs. Compressor	at _____			\$ _____	
					\$ _____	
	Trucking				\$ _____	
	Pav't Patch				\$ _____	
					\$ _____	
					\$ _____	
St. Coolidge  
 Pl. 27  
 Ave. No. 27  
 Name of Owner \_\_\_\_\_  
 TAX ID # 302.15-6-14

Labor and Mat'l. Report 19 4/11/13

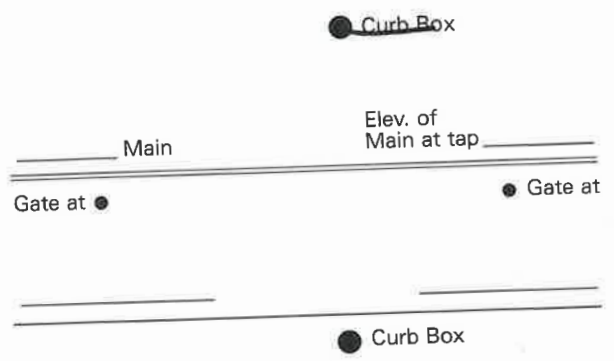

27 Feet TO  
 MAIN FROM OUTSIDE  
 CLEAR OUT

# LABOR AND MATERIALS

Copper } Connection \_\_\_\_\_ \$ \_\_\_\_\_  
 Lead }  
 Curb } Cock } \_\_\_\_\_ in. \_\_\_\_\_ \$ \_\_\_\_\_  
 Valve } T.S. & V. }  
 Service box { Short 3-1/2 x 4-1/2 } \_\_\_\_\_ \$ \_\_\_\_\_  
 Old returned { Long 4-1/2 x 5-1/2 }  
 Ft. \_\_\_\_\_ in. { Copper } Pipe at \_\_\_\_\_ \$ \_\_\_\_\_  
 { G.I. }  
 { C.I. }  
 Nipples \_\_\_\_\_ in. at \_\_\_\_\_ \$ \_\_\_\_\_  
 Bushings \_\_\_\_\_ to \_\_\_\_\_ in. at \_\_\_\_\_ \$ \_\_\_\_\_  
 Red'g \_\_\_\_\_  
 Inc'g \_\_\_\_\_  
 Union \_\_\_\_\_ in. at \_\_\_\_\_ \$ \_\_\_\_\_  
 Meter \_\_\_\_\_ in. at \_\_\_\_\_ \$ \_\_\_\_\_  
 \_\_\_\_\_ \$ \_\_\_\_\_  
 Compound Joints at \_\_\_\_\_ \$ \_\_\_\_\_  
 Maintenance Foreman \_\_\_\_\_ \$ \_\_\_\_\_  
 Hrs. Water Maint. Man - 1 at \_\_\_\_\_ \$ \_\_\_\_\_  
 Hrs. Water Maint. Man - 2 at \_\_\_\_\_ \$ \_\_\_\_\_  
 Hrs. Garage Foreman \_\_\_\_\_ at \_\_\_\_\_ \$ \_\_\_\_\_  
 Hrs. Labor \_\_\_\_\_ at \_\_\_\_\_ \$ \_\_\_\_\_  
 Hrs. Compressor at \_\_\_\_\_ \$ \_\_\_\_\_  
 \_\_\_\_\_ \$ \_\_\_\_\_  
 Trucking \_\_\_\_\_ \$ \_\_\_\_\_  
 Pav't Patch \_\_\_\_\_ \$ \_\_\_\_\_  
 \_\_\_\_\_ \$ \_\_\_\_\_  
 \_\_\_\_\_ \$ \_\_\_\_\_  
-St-  
 -Pl-  
 Ave. No. 27


COOLIDGE

Name of Owner

CHAS. PENFIELD

Labor and Mat'l. Report

JUNE 25 1937

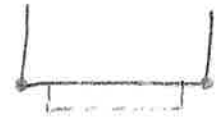

34'7" 40'11"

● Curb Box

6" Main

Elev. of Main at tap 5'

Gate at ●

● Gate at

● Curb Box

OLD SHUT OFF