

LABOR AND MATERIALS

1	Copper	} Connection	3/4"	\$	
	Lead				
1	Curb	} NEW ORISEAL 1968	in.	\$	
	Cock				
	Valve				
	T.S. & V.				
1	Service box	} Short 3 1/2 x 4 1/2	}	\$	
	Old returned			Long 4 1/2 x 5 1/2	
10	Ft. 3/4 in.	} Copper	} Pipe at	\$	
				G.I.	
				G.I.	
	Nipples	in. at		\$	
	Bushings	to in. at		\$	
	Red'g	} Coupl'gs	to in. at	\$	
	Inc'g				
	Union	in. at		\$	
	Meter	in. at		\$	
	Compound Joints	at		\$	
	Maintenance Foreman			\$	
	Hrs. Water Maint. Man-1	at		\$	
	Hrs. Water Maint. Man-2	at		\$	
	Hrs. Garage Foreman	at		\$	
	Hrs. Labor	at		\$	
	Hrs. Compressor	at		\$	
	Trucking			\$	
	Pav't Patch			\$	
				\$	
				\$	
COPPER REPLACED
3-20-68 DUE TO LEAK


COOLIDGE

St. _____
Pt. _____
Ave. No. 3

Name of Owner

Labor and Mat'l. Report

SEPT. 4 19 80

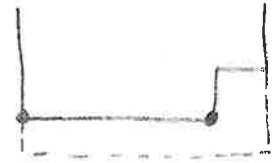

● Curb Box

6" Main

Elev. of Main at tap 5'

Gate at ●

● Gate at

● Curb Box

OLD TAP SHUT OFF