

COOLIDGE


St.
Pl.
Ave. No. 30

Name of Owner

REV. RICHARD ABBOT

Labor and Mat'l. Report

6-24 1937

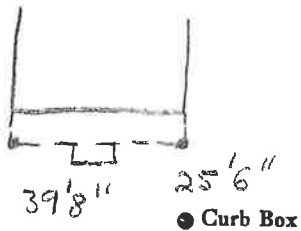

● Curb Box

6" Main

Elev. of
Main at tap 5'

Gate at ●

● Gate at

● Curb Box


OLD SHUT OFF

LABOR AND MATERIALS

1	Copper Lead	Connection	3/4	\$
1	Curb	Cock Valve T.S. & V.	3/4 in.	\$
1	Service box	Short 3 1/2 x 4 1/2		
	Old returned	Long 4 1/2 x 5 1/2		\$
32	Ft.	3/4 in. Copper	Pipe at	\$
		in. at		\$
		Bushings to in. at		\$
		Red'g Inc'g } Coupl'gs to in. at		\$
		Union in. at		\$
		Meter in. at		\$
				\$
		Compound Joints at		\$
		Maintenance Foreman		\$
		Hrs. Water Maint. Man-1 at		\$
		Hrs. Water Maint. Man-2 at		\$
		Hrs. Garage Foreman at		\$
		Hrs. Labor at		\$
		Hrs. Compressor at		\$
				\$
		Trucking		\$
		Pav't Patch		\$
				\$
				\$
Coolidge ~~St~~ Ave. No. 30
 Name of Owner

Labor and Mat'l. Report 19

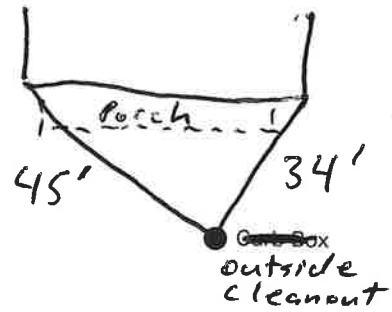

_____ Main
 Elev. of Main at tap _____
 Gate at ● _____ ● Gate at _____

 ● Curb Box

LABOR AND MATERIALS

- _____ Copper } Connection _____ \$ _____
- _____ Lead } _____
- _____ Curb } Cock _____ in. \$ _____
- _____ Valve } T.S. & V. }
- _____ Service box { Short 3-1/2 x 4-1/2 } \$ _____
- _____ Old returned { Long 4-1/2 x 5-1/2 }
- _____ Ft. _____ in. { Copper } Pipe at _____ \$ _____
- _____ G.I. }
- _____ C.I. }
- _____ Nipples _____ in. at _____ \$ _____
- _____ Bushings _____ to _____ in. at _____ \$ _____
- _____ Red'g _____
- _____ Inc'g _____
- _____ Union _____ in. at _____ \$ _____
- _____ Meter _____ in. at _____ \$ _____
- _____ \$ _____
- _____ Compound Joints at _____ \$ _____
- _____ Maintenance Foreman _____ \$ _____
- _____ Hrs. Water Maint. Man - 1 at _____ \$ _____
- _____ Hrs. Water Maint. Man - 2 at _____ \$ _____
- _____ Hrs. Garage Foreman _____ at _____ \$ _____
- _____ Hrs. Labor _____ at _____ \$ _____
- _____ Hrs. Compressor at _____ \$ _____
- _____ \$ _____
- _____ Trucking _____ \$ _____
- _____ Pav't Patch _____ \$ _____
- _____ \$ _____
- _____ \$ _____
