


LABOR AND MATERIALS

1	Copper Lead	} Connection ^{3/4"}	\$
1	Curb		} ^{3/4"} in.
1	Service box Old returned	} Short 3 1/2 x 4 1/2 } Long 4 1/2 x 5 1/2 }	\$
30	Ft. ^{3/4"} in.		} C.I. C.I. } Copper
	Nipples	in. at	\$
	Bushings	to in. at	\$
	Red'g Inc'g	} Coupl'gs to in. at	\$
	Union		in. at
	Meter	in. at	\$
	Compound Joints	at	\$
	Maintenance Foreman		\$
	Hrs. Water Maint. Man-1	at	\$
	Hrs. Water Maint. Man-2	at	\$
	Hrs. Garage Foreman	at	\$
	Hrs. Labor	at	\$
	Hrs. Compressor	at	\$
	Trucking		\$
	Pav't Patch		\$
			\$
			\$
St. COOLIDGE
Pl. 4
Ave. No. 4

Name of Owner
BEECHER HORTON

Labor and Mat'l. Report JULY 21 19 37

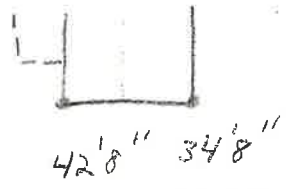

● Curb Box

6" Main Elev. of Main at tap 5'

Gate at ● Gate at ●

● Curb Box

OLD SHUT OFF