

1 1 0 - 1938

~~St.~~

Coolidge

~~Pl.~~

Ave. No. 62


Name of Owner

Washer

Labor and Mat'l. Report

Aug 24

1938

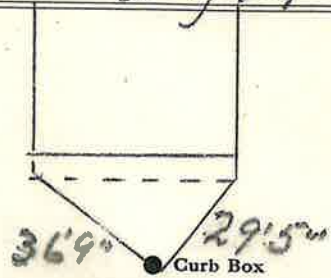

6 Main

Elev. of
Main at tap 4 1/2

Gate at ●

● Gate at

● Curb Box

~~7/11.~~
Old shut off

LABOR AND MATERIALS

1	Copper Lead	Connection	$\frac{3}{4}$		\$ 1.23
1	Curb	Cock Valve T.S. & V.	$\frac{3}{4}$	in.	\$ 1.68
1	Service Box Old returned	Short $3\frac{1}{2} \times 4\frac{1}{2}$ Long $4\frac{1}{2} \times 5\frac{1}{2}$ Buff. or Rdway			\$ 1.75
8	Ft. $\frac{3}{4}$ in.	Copper Galv Iron Cast Iron		Pipe at	\$ 1.20
	Nipples		in. at		\$
	Bushings		to in. at		\$
	Red'g Inc'g	Couplings	to in. at		\$
	Union		in. at		\$
	Meter		in. at		\$
	Lead Joints		at		\$
	Leadite Joints		at		\$
	Hrs. Foreman		at		\$
5	Hrs. Chauffeur		at		\$ 3.13
2	Hrs. Tapper		at		\$ 1.25
11	Hrs. Labor		at		\$ 4.95
	Hrs. Labor		at		\$
	Hrs. Compressor		at		\$
	Compensation Ins.				\$ 1.29
	Trucking				\$ 1.00
	Builders Use of Water	<u>no patch (B.P.)</u>			\$
	<u>Tap by Hessel</u>				\$
					\$
					\$
					\$ 16.48

29