


COOLIDGE

St. PL
Ave. No. 65

Name of Owner

Labor and Mat'l. Report

19

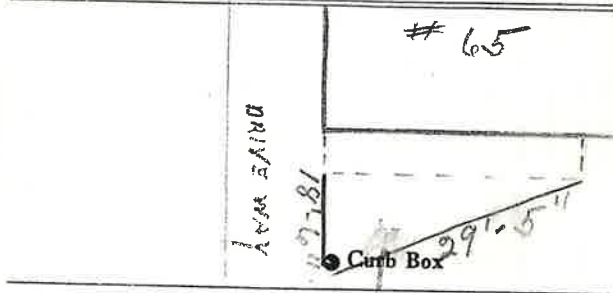

Main Elev. of
Main at tap

Gate at ● ● Gate at

● Curb Box

Tap is 3/4" not 8". Verified by
billing records 3/15/16 MS

LSM-5C-6-1-67

LABOR AND MATERIALS

Copper	Connection	_____	\$ _____
Lead	Cock	_____	\$ _____
Curb	Valve	_____ in.	\$ _____
	T. S. & V.	_____	\$ _____
Service box	Short 3 1/2 x 4 1/2 Long 4 1/2 x 5 1/2 Buff or Rdway	_____	\$ _____
Old returned		_____	\$ _____
40" Ft. 8" TO MAIN	Copper G. I. C. I.	Pipe at _____	\$ _____
		Nipples _____ in. at _____	\$ _____
		Bushings _____ to _____ in. at _____	\$ _____
Red'g	Coupl'gs	_____ to _____ in. at _____	\$ _____
Inc'g		_____	\$ _____
Union	_____ in. at _____	\$ _____	
Meter	_____ in. at _____	\$ _____	
Lead Joints	at _____	\$ _____	
Compound Joints	at _____	\$ _____	
Maintenance Foreman	_____	\$ _____	
Hrs. Water Maint. Man-1	at _____	\$ _____	
Hrs. Water Maint. Man-2	at _____	\$ _____	
Hrs. Garage Foreman	at _____	\$ _____	
Hrs. Labor	at _____	\$ _____	
Hrs. Compressor	at _____	\$ _____	
Compensation Ins.	at \$ _____ per C.	\$ _____	
Trucking	_____	\$ _____	
Pav't Patch	_____	\$ _____	
O'head	_____	\$ _____	