

103 - 1938

*Coolidge*


St. Ave. No. *68*

Name of Owner

*Malone*

Labor and Mat'l. Report

*Sept 8 1938*

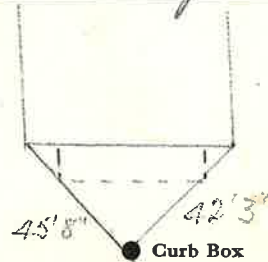

*6*\"/>

Elev. of Main at tap *4 1/2*

Gate at ●

● Gate at

● Curb Box

*New House*

LABOR AND MATERIALS

1	Copper	Connection	<i>3/4</i>	\$	<i>1.23</i>
1	Curb	Cock Valve T. S. & V.	<i>3/4</i> in.	\$	<i>1.68</i>
1	Service Box Old returned	Short <i>3 1/2 x 4 1/2</i> Long <i>4 1/2 x 5 1/2</i> Buff. on Rdway		\$	<i>1.75</i>
4	Ft.	<i>3/4</i> in. Copper Galv Iron Cast Iron	Pipe at <i>15</i>	\$	<i>1.60</i>
	Nipples	in. at		\$	
	Bushings	to in. at		\$	
	Red'g Inc'g	Couplings to in. at		\$	
	Union	in. at		\$	
	Meter	in. at		\$	
	Lead Joints	at		\$	
	Leadite Joints	at		\$	
	Hrs. Foreman	at		\$	
<i>5</i>	Hrs. Chauffeur	at <i>62 1/2</i>		\$	<i>3.13</i>
	Hrs. Tapper	at		\$	
<i>9</i>	Hrs. Labor	at <i>45</i>		\$	<i>4.05</i>
	Hrs. Labor	at		\$	
	Hrs. Compressor	at		\$	
	Compensation Ins.			\$	<i>2.2</i>
	Trucking			\$	<i>1.00</i>
	Builders Use of Water	(Sewer) Total		\$	
	<i>Tap by Benor</i>			\$	
				\$	
				\$	
				\$	<i>13.66</i>

*89*