


111-36

St. \_\_\_\_\_  
Pl. \_\_\_\_\_  
Ave. No. 76

Name of Owner \_\_\_\_\_

Labor and Mat'l. Report Sept. 22 <sup>29</sup> 1936

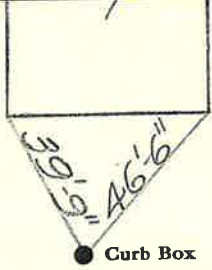

6" Main Elev. of Main at tap 5'

Gate at ● Gate at ●

● Curb Box

LABOR AND MATERIALS 76

1	Copper	Connection	<u>3/4</u>	\$
1	Curb	Cock	<u>3/4</u> in.	\$
		T. S. & V.		
1	Service Box	Short <u>3 1/2 x 4 1/2</u>		\$
	Old returned	Long <u>4 1/2 x 5 1/2</u>		
		Buff. or Rdway		
12	Ft. <u>3/4</u>	Copper	Pipe at	\$
		Galv. Iron		
		Cast Iron		
	Nipples	in. at		\$
	Bushings	to in. at		\$
	Red'g	Couplings	to in. at	\$
	Inc'g			
	Union	in. at		\$
	Meter	in. at		\$
	Lead Joints	at		\$
	Leadite Joints	at		\$
	Hrs. Foreman	at		\$
	Hrs. Chauffeur	at		\$
	Hrs. Tapper	at		\$
	Hrs. Labor	at		\$
	Hrs. Labor	at		\$
	Hrs. Compressor	at		\$
	Compensation Ins.			\$
	Trucking			\$
	Builders Use of Water			\$
				\$
				\$
28  
70