


46 - 1938

Str 85  
Pl  
Ave. No. 79

Coolidge

Name of Owner  
Francis

Labor and Mat'l. Report July 22 1938

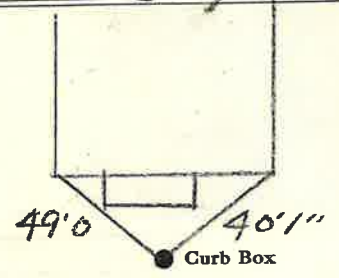

6 Main Elev. of Main at tap 7 1/2  
Gate at ● Gate at ●

● Curb Box

New House

LABOR AND MATERIALS

1	Copper Lead	Connection	3/4	\$ 1.23
1	Curb	Cock Valve T.S. & V.	3/4 in.	\$ 1.68
1	Service Box	Short 3/2x4 1/2	}	\$ 1.75
	Old returned	Long 4/2x5 1/2		
44	Ft. 3/4 in.	Copper Galv Iron Cast Iron	Pipe at 15	\$ 6.60
	Nipples	in. at		\$
	Bushings	to in. at		\$
	Red'g Inc'g	Couplings to in. at		\$
	Union	in. at		\$
	Meter	in. at		\$
	Lead Joints	at		\$
	Leadite Joints	at		\$
	Hrs. Foreman	at		\$
3	Hrs. Chauffeur	at 6 1/2		\$ 1.88
8	Hrs. Tapper	at		\$ 5.00
8	Hrs. Labor	at 4 5		\$ 3.60
	Hrs. Labor	at		\$
	Hrs. Compressor	at		\$
	Compensation Ins.			\$ .32
	Trucking			\$ 1.00
	Builders Use of Water			\$
	Tap by Hassell			\$
	1/2 Patch (Sewer)			\$ 2.50
				\$
				\$ 25.56

98