

20 -- 1939

#88

St. ---
Pl. *Hot*
Ave. No. *847.90*

Coalidge



Name of Owner

Albert Reed

Labor and Mat'l. Report

May 8

1939

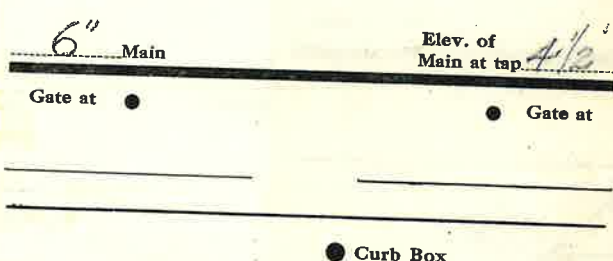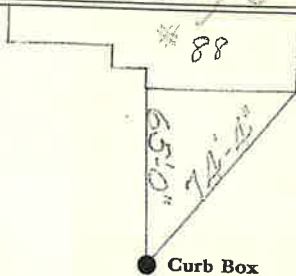

Gate at
1 7/8



1952

78

New House 466

LABOR AND MATERIALS

1	Copper Lead Connection		\$ 1.23
1	Curb { Cock Valve } <i>3/4</i> in.		\$ 1.68
1	Service Box { Short <i>3 1/2 x 4 1/2</i> Long <i>4 1/2 x 5 1/2</i> Buff. or Rdway } Old returned		\$ 1.54
5	Ft. <i>3/4</i> in. { Copper Galv Iron Cast Iron } Pipe at 17		\$.85
	Nipples	in. at	\$
	Bushings	to in. at	\$
	Red'g Inc'g	Couplings to in. at	\$
	Union	in. at	\$
	Meter	in. at	\$
	Lead Joints	at	\$
	Leadite Joints	at	\$
	Hrs. Foreman	at	\$
2	Hrs. Chauffeur	<i>6 1/2</i>	\$ 1.25
1	Hrs. Tapper	<i>1</i>	\$.63
9	Hrs. Labor	<i>45</i>	\$ 4.05
	Hrs. Labor	at	\$
1	Hrs. Compressor	<i>.65</i>	\$.65
	Compensation Ins.		\$.18
	Trucking		\$ 1-
	Builders Use of Water		\$
	Tap by Hessel		\$
	Patch - 1/2 on Sewer Dept		\$ 2.50
			\$
			\$ 15.56

06 - 28