


LABOR AND MATERIALS

1	Copper Lead	Connection	3/4"	\$
1	Curb	Cock Valve T.S. & V.	3/4" in.	\$
1	Service box Old returned	Short 3 1/2 x 4 1/2 Long 4 1/2 x 5 1/2		\$
20	Ft.	Copper C.I. C.I.	3/4" in. Pipe at	\$
	Nipples		in. at	\$
	Bushings		to in. at	\$
	Red'g Inc'g	Coupl'gs	to in. at	\$
	Union		in. at	\$
	Meter		in. at	\$
	Compound Joints		at	\$
	Maintenance Foreman			\$
	Hrs. Water Maint. Man-1		at	\$
	Hrs. Water Maint. Man-2		at	\$
	Hrs. Garage Foreman		at	\$
	Hrs. Labor		at	\$
	Hrs. Compressor		at	\$
	Trucking			\$
	Pav't Patch			\$
				\$
				\$
St. COOLIDGE
 Pl. 7
 Ave. No. 7
 Name of Owner MRS. EUGENE ASHLEY

Labor and Mat'l. Report JULY 1937

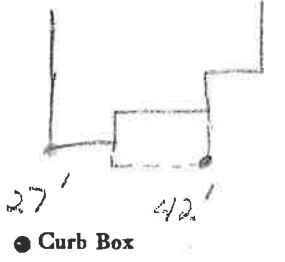

6" Main Elev. of Main at tap 5'
 Gate at ● Gate at ●

● Curb Box

OLD SHUT OFF