

69-1951


Coolidge

St. Ave. No. 95

Name of Owner

Darby

Labor and Mat'l. Report May 7 1951

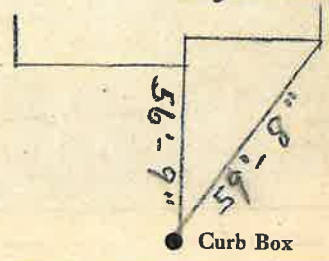

12" Main Elev. of Main at tap 4'

Gate at • Gate at •

• Curb Box

LABOR AND MATERIALS

1	Copper	Connection	3/4"	\$	3.04
1	Lead				
1	Curb	Cock Valve	3/4" in.	\$	3.54
		F.S. & V.			
1	Service box	Short 3 1/2 x 4 1/2			
25	Old returned	Long 4 1/2 x 5 1/2		\$	4.70
40	Ft. 3/4 in.	Copper			
15 ft		G.I.			
		G.I.	Pipe at 35	\$	8.75
	Nipples	in. at		\$	
	Bushings	to in. at		\$	
	Red'g	Coupl'gs to in. at		\$	
	Inc'g			\$	
	Union	in. at		\$	
	Meter	in. at		\$	
	Lead Joints	at		\$	
	Compound Joints	at		\$	
	Hrs. Water Maint. Man-1	at		\$	
	Hrs. Water Maint. Man-2	at		\$	
2	Hrs. Labor	at	1.26	\$	2.52
4	Hrs. Labor	at	1.02	\$	4.08
	Hrs. Compressor	at		\$	
	Compensation Ins.	at \$ per C.	19	\$	1.00
	Trucking			\$	
	Pav't Patch	outside		\$	
	O'head			\$	
	Tap by Gifford			\$	27.81
	5-7-51				6.00

96