


LABOR AND MATERIALS

1	Copper Lead	} Connection	3/4	_____	\$ _____
1	Curb				
1	Service box Old returned	} Short 3 1/2 x 4 1/2 Long 4 1/2 x 5 1/2	}	_____	\$ _____
31	Ft. 3/4 in.				
	Nipples _____ in. at _____	\$ _____			
	Bushings _____ to _____ in. at _____	\$ _____			
	Red'g Inc'g } Coupl'gs _____ to _____ in. at _____	\$ _____			
	Union _____ in. at _____	\$ _____			
	Meter _____ in. at _____	\$ _____			
	Compound Joints at _____	\$ _____			
	Maintenance Foreman _____	\$ _____			
	Hrs. Water Maint. Man-1 at _____	\$ _____			
	Hrs. Water Maint. Man-2 at _____	\$ _____			
	Hrs. Garage Foreman _____ at _____	\$ _____			
	Hrs. Labor _____ at _____	\$ _____			
	Hrs. Compressor at _____	\$ _____			
	Trucking _____	\$ _____			
	Pav't Patch _____	\$ _____			
	_____	\$ _____			
	_____	\$ _____			
COOLIDGE ~~St.~~  
~~Pl.~~  
Ave. No. 8

Name of Owner  
GRAY SAFFORD

Labor and Mat'l. Report 7-3-1937

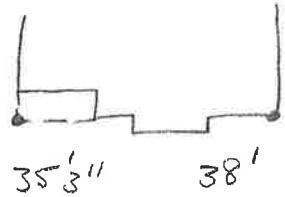

● Curb Box

6" Main Elev. of  
Main at tap 5'

Gate at ● ● Gate at

● Curb Box

OLD SHUT OFF