

LABOR AND MATERIALS

Copper	} Connection	_____	\$ _____	
Lead				
Curb	} Cock Valve T. S. & V.	_____ in.	\$ _____	
Service box		} Short 3½ x 4½ Long 4½ x 5½ Buff or Rdway	_____	\$ _____
Old returned				
15 Ft. 3 in.	} Copper C.P. C.P.		Pipe at _____	\$ _____
Nipples		_____ in. at _____	\$ _____	
Bushings	_____ to _____ in.	at _____	\$ _____	
Red'g } Inc'g }	} Coupl'gs	_____ to _____ in.	at _____ \$ _____	
Union		_____ in.	at _____ \$ _____	
Meter	_____ in.	at _____ \$ _____		
Lead Joints	at _____	\$ _____		
Compound Joints	at _____	\$ _____		
Maintenance Foreman	_____	\$ _____		
Hrs. Water Maint. Man-1	at _____	\$ _____		
Hrs. Water Maint. Man-2	at _____	\$ _____		
Hrs. Garage Foreman	at _____	\$ _____		
Hrs. Labor	_____ at _____	\$ _____		
Hrs. Compressor	at _____	\$ _____		
Compensation Ins.	at \$ _____ per C	\$ _____		
Trucking	_____	\$ _____		
Pav't Patch	_____	\$ _____		
_____		\$ _____		
_____		\$ _____		
O'head	_____	\$ _____		
_____		\$ _____		

St. _____
Pt. _____
Ave. No. 8


COOPER

Name of Owner

BERNARD KNAPP

Labor and Mat'l. Report

OCT 1980

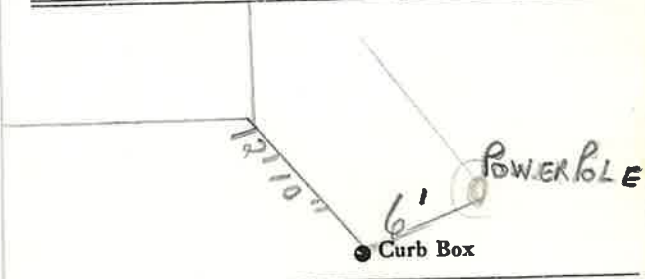

	Elev. of Main at tap _____	
_____ Main		
Gate at ●		● Gate at
_____		_____
		● Curb Box