

# LABOR AND MATERIALS

Copper	{ Connection	$1\frac{1}{4}$	\$	7.81
Lead				
Curb	{ Cock Valve P.S. & V.	$1\frac{1}{4}$ in.	\$	7.22
Service box	{ Short $3\frac{1}{2} \times 4\frac{1}{2}$			
Old returned	{ Long $4\frac{1}{2} \times 5\frac{1}{2}$			
	{ Buff or Rdway	same	\$	—
14 Ft. $1\frac{1}{4}$ in.	{ Copper			
	{ G.I.			
	{ C.I.	Pipe at 49.3	\$	6.90
Nipples	in. at		\$	
Bushings	to in. at		\$	
Red'g Inc'g	{ Coupl'gs to in. at		\$	
Union	in. at		\$	
Meter	in. at		\$	
Lead Joints	at		\$	
Compound Joints	at		\$	
Hrs. Water Maint. Man—1	at		\$	
Hrs. Water Maint. Man—2	at	1.02	\$	4.08
Hrs. Labor—	at	91	\$	7.28
Hrs. Labor—	at		\$	
Hrs. Compressor	at		\$	
Compensation Ins.	at \$ 2.18 per C.		\$	1.25
Trucking			\$	
Pav't Patch			\$	
Pay by Magnium			\$	
O'head			\$	
			\$	33.54

St. Pt. Ave. No. 42

Cooper


Name of Owner

City Street Dept

Labor and Mat'l. Report

Oct 30

1947

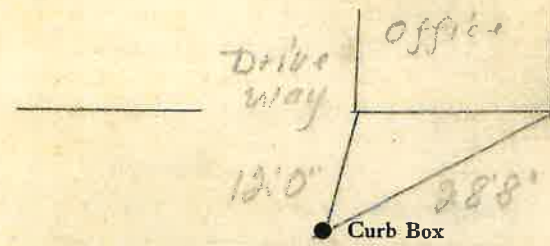

6 Main

Elev. of Main at tap 4 1/2

Gate at ●

● Gate at

● Curb Box