

LABOR AND MATERIALS

Copper	} Connection	_____	\$
Lead		_____	\$
Curb	} Cock Valve T. S. & V. }	_____ in.	\$
Service box		} Short 3½ x 4½ Long 4½ x 5½ }	_____
Old returned			_____
20 Ft. 1/4" in.	} <del>Copper</del> G. I. <del>G. I.</del> }	Pipe at _____	\$
Nipples		_____ in. at _____	\$
Bushings	_____ to _____ in.	at _____	\$
Red'g	} Coupl'gs	_____ to _____ in.	at _____
Inc'g		_____	\$
Union	_____ in.	at _____	\$
Meter	_____ in.	at _____	\$
Compound Joints	at _____	\$	
Maintenance Foreman	_____	\$	
Hrs. Water Maint. Man—1	at _____	\$	
Hrs. Water Maint. Man—2	at _____	\$	
Hrs. Garage Foreman	_____ at _____	\$	
Hrs. Labor	_____ at _____	\$	
Hrs. Compressor	at _____	\$	
Trucking	_____	\$	
Pav't Patch	_____	\$	
		\$	
		\$	
COOPER


St. ~~Pl.~~  
Ave. No. 47

Name of Owner

MACHINE SHOP

Labor and Mat'l. Report

1923

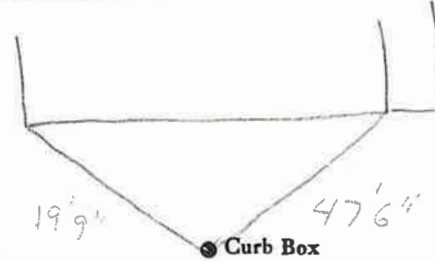

Main

Elev. of  
Main at tap

Gate at ●

● Gate at

TAX ID # 303.13-19-17

● Curb Box