


LABOR AND MATERIALS

1	Copper Lead	} Connection	3/4	\$	
1	Curb			} Cock Valve T.S. & V.	3/4 in.
1	Service box	} Short 3 1/2 x 4 1/2 } Long 4 1/2 x 5 1/2 }			
	Old returned				\$
27	Ft.	} Copper } G.I. } G.I. }	3/4 in.	} Pipe at	\$
	Nipples				in. at
1	Bushings	3/4 to 1/2	in. at	\$	
1	Red'g Inse'g	} Coupl'gs	to	in. at	\$
1	Union				1/2
	Meter		in. at	\$	
	Compound Joints		at	\$	
	Maintenance Foreman			\$	
	Hrs. Water Maint. Man	1	at	\$	
	Hrs. Water Maint. Man	2	at	\$	
	Hrs. Garage Foreman		at	\$	
	Hrs. Labor		at	\$	
	Hrs. Compressor		at	\$	
	Trucking			\$	
	Pav't Patch			\$	
				\$	
				\$	
				\$	
				\$	

COOPER St. No. 63
 Name of Owner

Labor and Mat'l. Report JUNE 16 1928

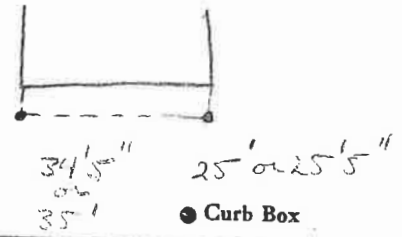

4" Main Elev. of Main at tap 4'

Gate at • Gate at •

TAX ID # 303.13-19-13

• Curb Box

OLD SHUT OFF