
LABOR AND MATERIALS Copper) Connection Cock Valve T.S.&V. Curb Short 31/2 x 41/2 Long 41/2 x 51/2 Service box Old returned 25 Ft. 3/4 in. Copper G. I. Pipe at Nipples_ in. a Bushings. in. at Red'g } Coupl'gs BRASS in. a _Union. in. at Meter in. at. Compound Joints at Maintenance ForemanHrs. Garage Foremanat Hrs. Labor- _____at____ Hrs. Compressor at.... ____Trucking _Pav't Patch_

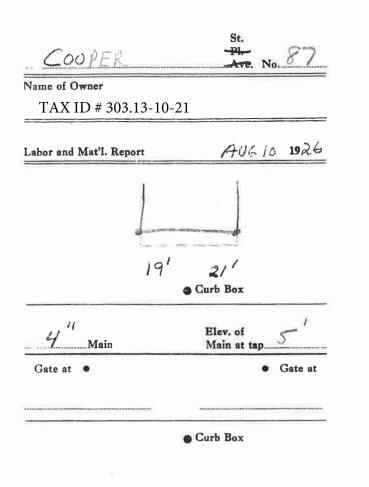

LSM-5C-6-1-67