

LABOR AND MATERIALS

Copper	} Connection	_____	\$ _____	
Lead				
Curb	} _____ in.	_____	\$ _____	
				Cock
				Valve
	T. S. & V.			
Service box	} Short 3 1/2 x 4 1/2	_____	\$ _____	
Old returned				Long 4 1/2 x 5 1/2
Ft. <u>3/4</u> in.	} Pipe at	_____	\$ _____	
				Copper
	G. I.			
	C. I.			
Nipples	in. at	_____	\$ _____	
Bushings	to _____ in.	at _____	\$ _____	
Red'g	} Coupl'gs	to _____ in.	at _____ \$ _____	
Inc'g				
Union	in. at	_____	\$ _____	
Meter	in. at	_____	\$ _____	
Compound Joints	at	_____	\$ _____	
Maintenance Foreman		_____	\$ _____	
Hrs. Water Maint. Man—1	at	_____	\$ _____	
Hrs. Water Maint. Man—2	at	_____	\$ _____	
Hrs. Garage Foreman	at	_____	\$ _____	
Hrs. Labor—	at	_____	\$ _____	
Hrs. Compressor	at	_____	\$ _____	
Trucking		_____	\$ _____	
Pav't Patch		_____	\$ _____	
		_____	\$ _____	
		_____	\$ _____	

St. _____
 Pt. _____
 Ave. No. 94

COOPER

Name of Owner _____

TAX ID # 303.13-9-5

Labor and Mat'l. Report _____ 19 94

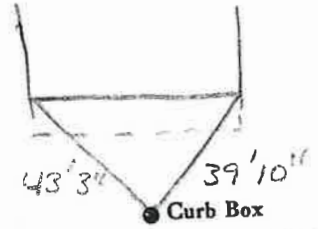

Main _____ Elev. of Main at tap _____

Gate at ● _____ Gate at ● _____

● Curb Box