


LABOR AND MATERIALS

1	Copper Lead	} Connection <u>3/4</u>	\$
1	Curb		\$
		} Cock Valve T.S. & V. } <u>3/4</u> in.	\$
1	Service box Old returned		{ Short $3\frac{1}{2} \times 4\frac{1}{2}$ Long $4\frac{1}{2} \times 5\frac{1}{2}$ }
22	Ft. <u>3/4</u> in.	{ Copper C.I. C.I. } Pipe at	\$
	Nipples	in. at	\$
	Bushings	to in. at	\$
1	Red'g Inc'g	} Coupl'gs <u>3/4</u> to	\$
	Union		in. at
	Meter	in. at	\$
			\$
	Compound Joints	at	\$
	Maintenance Foreman		\$
	Hrs. Water Maint. Man—1	at	\$
	Hrs. Water Maint. Man—2	at	\$
	Hrs. Garage Foreman	at	\$
	Hrs. Labor—	at	\$
	Hrs. Compressor	at	\$
			\$
	Trucking		\$
	Pav't Patch		\$
			\$
			\$
			\$
			\$

St. COOPER
 Pt. 95
 Ave. No. 95
 Name of Owner
 TAX ID # 303.13-10-17

Labor and Mat'l. Report APR 26 1926

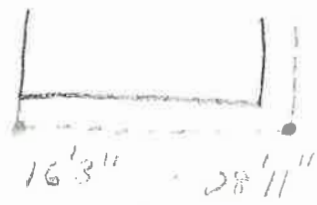

● Curb Box

4" Main Elev. of Main at tap 5'
 Gate at ● Gate at ●

● Curb Box

LSM-SC-6-1-67

16' 3" 28' 11"