

## LABOR AND MATERIALS

|    |                             |   |           |                                   |                 |         |
|----|-----------------------------|---|-----------|-----------------------------------|-----------------|---------|
| 1  | Copper<br><del>Lead</del>   | Connection  | 3         |                                   | \$ 1.23         |         |
| 1  | Curb                        | Cock<br>Valve<br>T. S. & V.                                 | 3         | in.                               | \$ 1.68         |         |
| 1  | Service Box<br>Old returned | Short 3 1/2 x 4 1/2<br>Long 4 1/2 x 5 1/2<br>Buff. on Rdway |           |                                   |                 | \$ 1.75 |
| 26 | Ft.                         | in.   | 3<br>7    | Copper<br>Galv. Iron<br>Cast Iron | Pipe at \$ 3.90 |         |
|    | Nipples                     | in. at  |           |                                   | \$              |         |
|    | Bushings                    | to in. at   |           |                                   | \$              |         |
|    | Red'g<br>Inc'g              | Couplings   | to in. at |                                   | \$              |         |
|    | Union                       | in. at  |           |                                   | \$              |         |
|    | Meter                       | in. at  |           |                                   | \$              |         |
|    | Lead Joints                 | at  |           |                                   | \$              |         |
|    | Leadite Joints              | at  |           |                                   | \$              |         |
|    | Hrs. Foreman                | at  |           |                                   | \$              |         |
| 4  | Hrs. Chauffeur              | at  | 6 1/2     |                                   | \$ 2.50         |         |
| 10 | Hrs. Tapper                 | at  |           |                                   | \$ 6.25         |         |
| 9  | Hrs. Labor                  | at  | 45        |                                   | \$ 4.05         |         |
|    | Hrs. Labor                  | at  |           |                                   | \$              |         |
|    | Hrs. Compressor             | at  |           |                                   | \$              |         |
|    | Compensation Ins.           |   |           |                                   | \$ .39          |         |
|    | Trucking                    |   |           |                                   | \$ 1.00         |         |
|    | Builders Use of Water       |   |           |                                   | \$              |         |
|    | Truck by Permit             |   |           |                                   | \$ 5.00         |         |
|    |                             |   |           |                                   | \$              |         |
|    |                             |   |           |                                   | \$              |         |
|    |                             |   |           |                                   | \$              |         |
|    |                             |   |           |                                   | \$ 27.75        |         |

85 - 1938

St. **103**

Pl. **77**


Ave. No. **77**

Name of Owner

*Savarny*

Labor and Mat'l. Report

1938

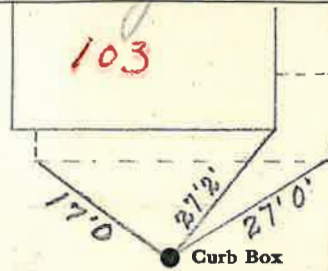

Main

Elev. of

Main at tap

Gate at ●

● Gate at

TAX ID # 303.13-10-13

● Curb Box

*old shut off*

*TH*