


LABOR AND MATERIALS

1	Copper Lead	Connection	3/4	\$
1	Curb	Cock Valve T.S. & V.	3/4 in.	\$
1	Service box Old returned	Short 3 1/2 x 4 1/2 Long 4 1/2 x 5 1/2		\$
31	Ft.	3/4 in. Copper C.T. C.T.	Pipe at	\$
	Nipples	in. at		\$
	Bushings	to in. at		\$
1	Red'g Inc'g	Coupl'gs BRASS	to in. at	\$
	Union	in. at		\$
	Meter	in. at		\$
	Compound Joints	at		\$
	Maintenance Foreman			\$
	Hrs. Water Maint. Man-1	at		\$
	Hrs. Water Maint. Man-2	at		\$
	Hrs. Garage Foreman	at		\$
	Hrs. Labor	at		\$
	Hrs. Compressor	at		\$
	Trucking			\$
	Pav't Patch			\$
				\$
				\$
St. ~~Pl.~~
Ave. No. 105
Name of Owner COOPER
TAX ID # 303.13-10-12

Labor and Mat'l. Report
JUNE 28 1928

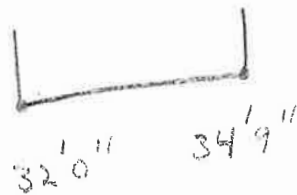

4" Main
Elev. of Main at tap 4'
Gate at • Gate at •
• Curb Box
• Curb Box