


LABOR AND MATERIALS

1 Copper } Connection 3/4" \$  
 1 Curb } Cock } 3/4" OPISAL \$  
 } Valve }  
 } T.S. & V. }  
 1 Service box { Short 3 1/2 x 4 1/2 } \$  
 Old returned { Long 4 1/2 x 5 1/2 } \$  
 { Buff or Rdway } \$  
26' 3/4" in. { Copper } Pipe at \$  
 { C.I. }  
 Nipples in. at \$  
 Bushings to in. at \$  
 Red'g }  
 Inc'g } Coupl'gs to in. at \$  
 Union in. at \$  
 Meter in. at \$  
 Lead Joints at \$  
 Compound Joints at \$  
 Maintenance Foreman \$  
 Hrs. Water Maint. Man-1 at \$  
 Hrs. Water Maint. Man-2 at \$  
 Hrs. Garage Foreman at \$  
 Hrs. Labor at \$  
 Hrs. Compressor at \$  
 Compensation Ins. at \$ per C \$  
 Trucking \$  
 Pav't Patch \$  
TAP MADE BY HAROLD \$  
TCO 7-16-76 \$  
 O'head \$  
 \$

COOPER St. Pl. Ave. No. 109

Name of Owner LARRY KELLY

Labor and Mat'l. Report July 17 1976

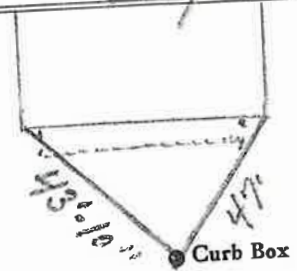

6" Main Elev. of Main at tap 4 1/2'

Gate at ● Gate at ●

TAX ID # 303.13-4-12

● Curb Box