


LABOR AND MATERIALS

| | | | | | | |
|----|-------------------------|----------------------|-----------|----|-----------------------|----|
| 1 | Copper | } Connection | 3/4 | \$ | | |
| | Lead | | | | | |
| 1 | Curb | } Cock Valve T.S.&V. | } 3/4 in. | \$ | | |
| 1 | Service box | | | | } Short 3 1/2 x 4 1/2 | \$ |
| | Old returned | | | | | |
| 10 | Ft. 3/4 in. | } Copper | } Pipe at | \$ | | |
| | | | | | } C.I. | |
| | Nipples | in. at | \$ | | | |
| | Bushings | to in. at | \$ | | | |
| | Red'g | } Coupl'gs | to in. at | \$ | | |
| | Inc'g | | | | | |
| | Union | in. at | \$ | | | |
| | Meter | in. at | \$ | | | |
| | | | \$ | | | |
| | Compound Joints | at | \$ | | | |
| | Maintenance Foreman | | \$ | | | |
| | Hrs. Water Maint. Man-1 | at | \$ | | | |
| | Hrs. Water Maint. Man-2 | at | \$ | | | |
| | Hrs. Garage Foreman | at | \$ | | | |
| | Hrs. Labor | at | \$ | | | |
| | Hrs. Compressor | at | \$ | | | |
| | | | \$ | | | |
| | Trucking | | \$ | | | |
| | Pav't Patch | | \$ | | | |
| | | | \$ | | | |
| | | | \$ | | | |
| | | | \$ | | | |
| | | | \$ | | | |

St. COOPER
~~Pl.~~
 Ave. No. 112

Name of Owner _____

Labor and Mat'l. Report AUG 3 1929

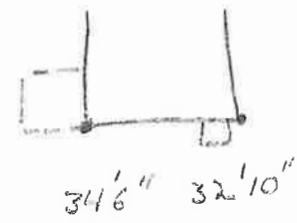

● Curb Box

6" Main Elev. of Main at tap 5'

Gate at ● Gate at

TAX ID # 303.13-3-1

● Curb Box