

LABOR AND MATERIALS

1	Copper Lead	Connection	3/4		\$ 1.35
1	Curb	Cock Valve T. S. & V.		in.	\$ 1.80
1	Service Box	Short 3 1/2 x 4 1/2 Long 4 1/2 x 5 1/2 Buffer Rdway			\$ 1.70
	Old returned				
24	Ft.		3/4	in.	Copper Galv Iron Cast Iron
	Nipples		in. at		\$
	Bushings		to in. at		\$
	Red'g Inc'g	Couplings		to in. at	\$
	Union			in. at	
	Meter		in. at		\$
	Lead Joints at				\$
	Leadite Joints at				\$
	Hrs. Foreman at				\$
6	Hrs. Chauffeur at	6 2/3			\$ 3.75
7	Hrs. Tapper at	"			\$ 4.38
15	Hrs. Labor at	45			\$ 5.85
	Hrs. Labor at				\$
1	Hrs. Compressor at	6 2/3			\$.63
	Compensation Ins.				\$ 43
	Trucking				\$ 1
	Builders Use of Water	Saled			\$ 5
	Tap by P.M.C.M.				\$
					\$
					\$
					\$ 30.21

89 1941

St. 119

Pl. 95


Ave. No. 765

Name of Owner

Stevens

Labor and Mat'l. Report

Sept 9 1941

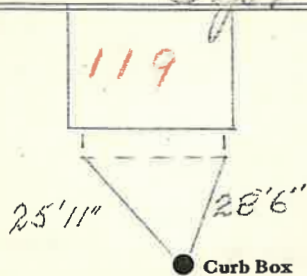

6" Main

Elev. of Main at tap 41'

Gate at ●

● Gate at

TAX ID # 303.13-4-9

● Curb Box