

### LABOR AND MATERIALS

1	Copper	Connection	3/4"		\$ 2.76
	Lead				
1	Curb	{ Gock Valve T.S. & V.	3/4 in.		\$ 3.49
1	Service box	Short 3 1/2 x 4 1/2			\$ 4.95
	Old returned	Long 4 1/2 x 5 1/2			
		Buff or Rdway			
23	Ft.	Copper	Pipe at 35		\$ 8.05
		G.I.			
		G.I.			
	Nipples	in. at			\$
	Bushings	to in. at			\$
	Red'g	{ Coupl'gs to in. at			\$
	Inc'g				
	Union	in. at			\$
	Meter	in. at			\$
	Lead Joints at				\$
	Compound Joints at				\$
6	Hrs. Water Maint. Man-1	at 1.34			\$ 8.04
	Hrs. Water Maint. Man-2	at			\$
6	Hrs. Labor	at 1.13			\$ 6.78
	Hrs. Labor	at			\$
	Hrs. Compressor at				\$
	Compensation Ins. at \$3.706 per C.				\$ 55
	Trucking				\$ 1.00
	Pav't Patch				\$ 5.40
					\$
					\$
					\$
	O'head				\$ 40.82

2542

Tap made June 11-52  
by Wansinger & Foster

St.  
Pl.  
Ave. No. 123


Cooper

Name of Owner

Wilcox

Labor and Mat'l. Report

June 11 1952

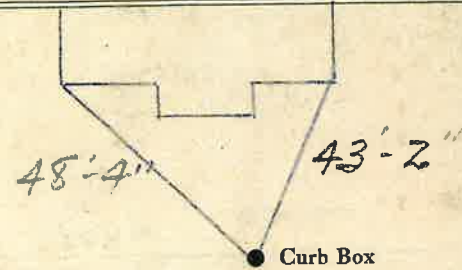

● Curb Box

6" Main

Elev. of  
Main at tap 4 1/2'

Gate at ●

● Gate at

● Curb Box