

LABOR AND MATERIALS


1	Copper	Connection	3/4"	\$ 2.71
1	Lead	Cock Valve	3/4" in.	\$ 3.83
1	Curb	T.S. & V.		
1	Service box	Short 3 1/2 x 4 1/2		
1	Old returned	Long 4 1/2 x 5 1/2		\$ 4.69
		Buff or Rdway		
12	Ft. 3/4 in.	Copper Pipe at	45	\$ 5.40
		G. I.		
		C. I.		
	Nipples	in. at		\$
	Bushings	to in. at		\$
	Red g			
	Inc'g	Coupl'gs to in. at		\$
	Union	in. at		\$
	Meter	in. at		\$
	Lead Joints	at		\$
	Compound Joints	at		\$
	Maintenance Foreman			\$ 9.26
	Hrs. Water Maint. Man-1	at		\$
2	Hrs. Water Maint. Man-2	at 1.24		\$ 2.48
	Hrs. Garage Foreman	at		\$
6	Hrs. Labor	at 1.13		\$ 6.78
	Hrs. Compressor	at		\$
	Compensation Ins. at	\$ 4.29 per C		\$ 4.00
	Trucking			\$ 1.50
	Pav't Patch			\$ 16.20
	Tap by Gifford			\$
	12-2-55			\$
	O'head			\$
				\$ 43.99

P Patch?
27.79

St. Cooper
Pl. 130
Ave. No. 130

Name of Owner Brunelle

Labor and Mat'l. Report Dec. 2 1955

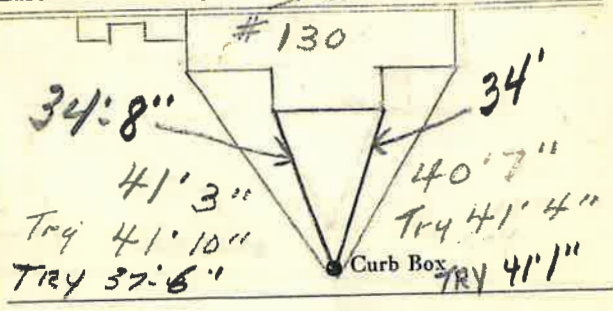

6" Main Elev. of Main at tap 4'

Gate at • Gate at

TAX ID # 303.13-3-7

• Curb Box