

LABOR AND MATERIALS


1 - Copper } Connection \$
 Lead }
 Curb } Cock Valve } in. \$
 } T. S. & V. }
 1 - Service Box } Short 3 1/2 x 4 1/2 }
 Old returned } Long 4 1/2 x 5 1/2 }
 } Buffer Rdway } \$
 19 Ft. 1/2 in. } Copper }
 } Galv Iron } Pipe at \$
 } Cast Iron }
 Nipples in. at \$
 Bushings to in. at \$
 Red'g } Couplings to in. at \$
 Inc'g }
 Union in. at \$
 Meter in. at \$
 Lead Joints at \$
 Leadite Joints at \$
 Hrs. Foreman at \$
 Hrs. Chauffeur' at \$
 Hrs. Tapper at \$
 Hrs. Labor at \$
 Hrs. Labor at \$
 Hrs. Compressor at \$
 Compensation Ins. \$
 Trucking \$
 Builders Use of Water \$
 \$
 \$
 \$
 \$

St. Pl.
Ave. No. 12

Cortland

Name of Owner
TAP MADE AUG 23, 1916

Labor and Mat'l. Report SEP 6 - 1939 19

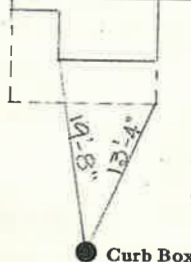

Elev. of Main at tap.....

6" Main

Gate at ● Gate at ●

19' to main

● Curb Box

Galv.

Tax Map #309.7-6-7