

## LABOR AND MATERIALS


Copper	{	Connection	.....	\$	
Lead					
Curb	{	Cock	.....	\$	
		Valve	..... in.	\$	
		T. S. & V.	.....	\$	
Service box	{	Short 3½x4½	.....	\$	
		Long 4½x5½	.....	\$	
		Buff or Rdway	.....	\$	
Old returned	{	Copper	.....	\$	
		C.I.	.....	\$	
Ft.	in.	} Pipe at	.....	\$	
Nipples	in. at		.....	\$	
Bushings	to	in. at	.....	\$	
Red'g	{	Coupl'gs	to	in. at	.....
			Ine'g	.....	\$
Union	in. at	.....	\$		
Meter	in. at	.....	\$		
Lead Joints at	.....	\$			
Compound Joints at	.....	\$			
Hrs. Water Maint. Man—1 at	.....	\$			
Hrs. Water Maint. Man—2 at	.....	\$			
Hrs. Labor—	at	.....	\$		
Hrs. Labor—	at	.....	\$		
Hrs. Compressor at	.....	\$			
Compensation Ins. at \$	per C.	.....	\$		
Trucking	.....	\$			
Pav't Patch	.....	\$			
.....	.....	\$			
.....	.....	\$			
O'head	.....	\$			
.....	.....	\$			

St. 24  
 Pt. 24  
 Ave. No. 24

Name of Owner \_\_\_\_\_

Measure in card 8-15-51

Labor and Mat'l. Report AUG 1927

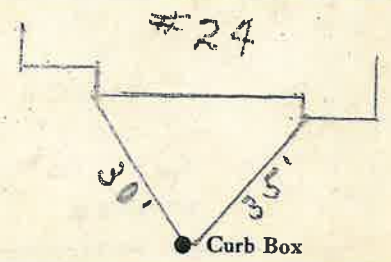

Main	Elev. of Main at tap
Gate at ●	● Gate at

● Curb Box