


LABOR AND MATERIALS

1	Copper Lead	Connection	3/4"	\$
1	Curb	Cock Valve T.S. & V.	3/4 in.	\$
1	Service box	Short 3 1/2 x 4 1/2 Long 4 1/2 x 5 1/2 Buff or Rdway		\$
	Old returned			\$
8	Ft.	Copper G.I. G.I.	3/4 in. Pipe at	\$
	Nipples		in. at	\$
	Bushings		to in. at	\$
	Red'g Inc'g	Coupl'gs	to in. at	\$
	Union		in. at	\$
	Meter		in. at	\$
	Lead Joints		at	\$
	Compound Joints		at	\$
	Maintenance Foreman			\$
	Hrs. Water Maint. Man	1	at	\$
	Hrs. Water Maint. Man	2	at	\$
	Hrs. Garage Foreman		at	\$
	Hrs. Labor		at	\$
	Hrs. Compressor		at	\$
	Compensation Ins.		at \$ per C	\$
	Trucking			\$
	Pav't Patch			\$
	Tap by Gifford & Co.			\$
	10-8-59.			\$
	O'head			\$
				\$

St. Cortland Ave. No. 3

Name of Owner T. Alfred Alkes.

Labor and Mat'l. Report Oct. 8 19 59

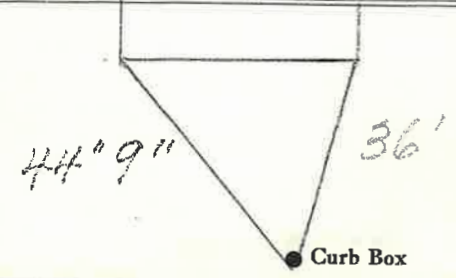

6" Main Elev. of Main at tap 5'

Gate at • Gate at •

8' to main

• Curb Box

Tax Map #309.7-7-12