


LABOR AND MATERIALS

1	Copper	} Connection	3/4"	\$
	Lead			
1	Curb	} Cock Valve	3/4 in. Oriseal.	\$
1	Service box	} { Short 3 1/2 x 4 1/2 Long 4 1/2 x 5 1/2 Buff or Rdway		\$
	Old returned			
23	Ft. 3/4 in.	} { Copper G.I. C.I.	} Pipe at	\$
	Nipples	in. at		\$
	Bushings	to in. at		\$
	Red'g	} Coupl'gs	to in. at	\$
	Inc'g			
	Union	in. at		\$
	Meter	in. at		\$
	Lead Joints	at		\$
	Compound Joints	at		\$
	Maintenance Foreman			\$
	Hrs. Water Maint. Man	1 at		\$
	Hrs. Water Maint. Man	2 at		\$
	Hrs. Garage Foreman	at		\$
	Hrs. Labor	at		\$
	Hrs. Compressor	at		\$
	Compensation Ins. at \$	per C		\$
	Trucking			\$
	Pav't Patch			\$
	Tap Made by Giffard & Co. 12-21-66.			\$
	O'head			\$

Cortland St. Pl. Ave. No. 8

Name of Owner Alkes.

Labor and Mat'l. Report Dec. 21 1966

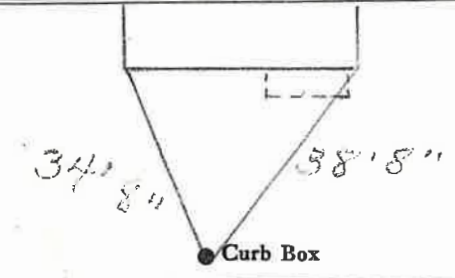

6" Main Elev. of Main at tap 5'

Gate at • Gate at

23' to main

• Curb Box

Tax Map #309.7-6-9