


LABOR AND MATERIALS

1 Copper } Connection 3/4" \$
 Lead }
 1 Curb } Cock } 3/4 in. Oriseal. \$
 } Valve }
 } T.S. & V. }
 1 Service box { Short 3 1/2 x 4 1/2 }
 Old returned { Long 4 1/2 x 5 1/2 } \$
 { Buff or Rdway }
 166' Ft. 3/4 in. { Copper } Pipe at \$
 } ~~C.I.~~ }
 } ~~C.I.~~ }
 Nipples in. at \$
 Bushings to in. at \$
 Red'g }
 Inc'g } Coupl'gs. to in. at \$
 Union in. at \$
 Meter in. at \$
 Lead Joints at \$
 Compound Joints at \$
 Maintenance Foreman \$
 Hrs. Water Maint. Man-1 at \$
 Hrs. Water Maint. Man-2 at \$
 Hrs. Garage Foreman at \$
 Hrs. Labor at \$
 Hrs. Compressor at \$
 Compensation Ins. at \$ per C \$
 Trucking \$
 Pav't Patch \$
 Tap by Gifford & Co. \$
10-14-65 \$
 O'head \$

Cottage St.
Pl.
Ave. No. 2
 Name of Owner
Frank Chenier

Labor and Mat'l. Report Oct 14 1965

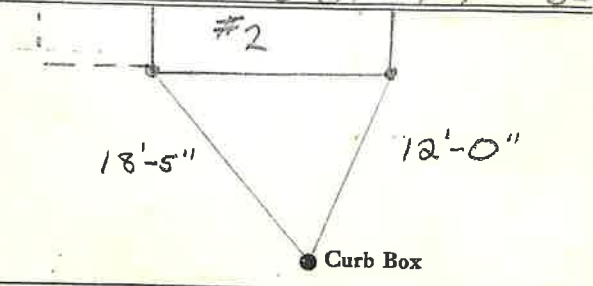

6" Main (1999) Elev. of Main at tap 5'

Gate at • Gate at

Re-measured 7-20-78

● Curb Box

Note:-
 Curb box inside
 of side walk.