

### LABOR AND MATERIALS

1	Copper Lead	Connection	3/4"		\$ 308
1	Curb	Cock Valve T.S. & V.	3/4 in.		\$ 389
1	Service box Old returned	Short 3 1/2 x 4 1/2 Long 4 1/2 x 5 1/2 Buff or Rdway			\$ 4.32
14	Ft.	Copper G.I. C.I.	3/4 in. } Pipe at 45		\$ 360
	Nipples	in. at			\$
	Bushings	to in. at			\$
	Red'g Inc'g	Coupl'gs	to in. at		\$
	Union	in. at			\$
	Meter	in. at			\$
	Lead Joints	at			\$
	Compound Joints	at			\$
	Maintenance Foreman				\$ 200
	Hrs. Water Maint. Man	1 at			\$
8	Hrs. Water Maint. Man	2 at 1.613			\$ 12.90
	Hrs. Garage Foreman	at			\$
7	Hrs. Labor	at 1.30			\$ 9.10
	Hrs. Compressor	at			\$
	Compensation Ins.	at \$ 5686 per C			\$ 1.25
	Trucking				\$ 1.50
	Pav't Patch				\$ 20.16
	Tap by Gissard + Peterson 5-8-56				\$
	O'head				\$
					\$
					\$ 59.90


St.  
Pl.  
Ave. No. 6

Cottage

Name of Owner

Parrow.

Labor and Mat'l. Report May 8 1956

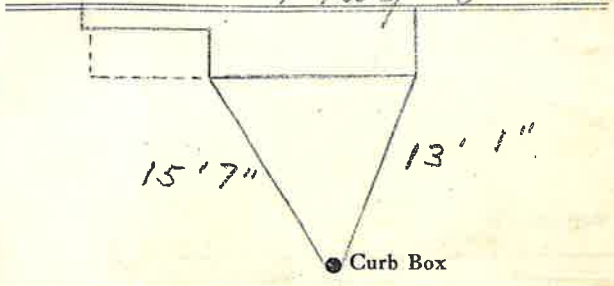

6" Main (1999)      Elev. of Main at tap 5'

Gate at •      • Gate at

• Curb Box