

### LABOR AND MATERIALS


Copper	}	Connection		\$
Lead				
Curb	}	Cock	in.	\$
		Valve		
		T. S. & V.		
Service box	}	Short 3½ x 4½		
Old returned		Long 4½ x 5½		
		Buff or Rdway		\$
<del>18</del> 17 Ft.	}	Copper	in.	
<del>18</del> 3/4		G.I.		
		C.I.	Pipe at	\$
Nipples		in. at		\$
Bushings		to in. at		\$
Red'g	}	Coupl'gs	to in. at	\$
Inc'g				
Union		in. at		\$
Meter		in. at		\$
Lead Joints		at		\$
Compound Joints		at		\$
Maintenance Foreman				\$
Hrs. Water Maint. Man-1		at		\$
Hrs. Water Maint. Man-2		at		\$
Hrs. Garage Foreman		at		\$
Hrs. Labor		at		\$
Hrs. Compressor		at		\$
Compensation Ins. at \$		per C		\$
Trucking				\$
Pav't Patch				\$
				\$
				\$
O'head				\$
				\$

St.             
Pl.             
Ave. No. 3

Cottage

Name of Owner \_\_\_\_\_

Labor and Mat'l. Report 19

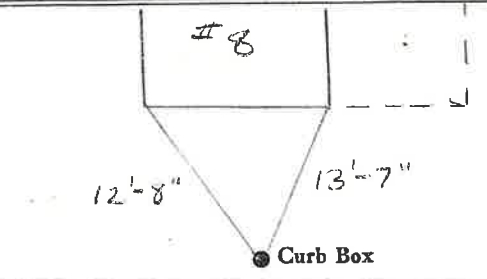

6" Main (1999) Elev. of Main at tap 5'

Gate at • • Gate at

● Curb Box

Re-measured 7-20-78

JER