

LABOR AND MATERIALS

	Copper Lead	Connection			\$
	Curb	Cock Valve T.S. & V.	in.		\$
	Service box Old returned	Short 3½ x 4½ Long 4½ x 5½ Buff or Rdway			\$
14	Ft. 1	Copper G. I. C.I.	in.	} Pipe at	\$
	Nipples	in.			\$
	Bushings	to	in.		\$
	Red'g Inc'g	Coupl'gs	to	in.	\$
	Union	in.			\$
	Meter	in.			\$
	Lead Joints				\$
	Compound Joints				\$
	Maintenance Foreman				\$
	Hrs. Water Maint. Man-1	at			\$
	Hrs. Water Maint. Man-2	at			\$
	Hrs. Garage Foreman	at			\$
	Hrs. Labor	at			\$
	Hrs. Compressor	at			\$
	Compensation Ins. at \$		per C		\$
	Trucking				\$
	Pav't Patch				\$
					\$
					\$
					\$
	O'head				\$
					\$


Crandall

St.
Pl. No. **3**
Ave. No.

Name of Owner

Labor and Mat'l. Report

19

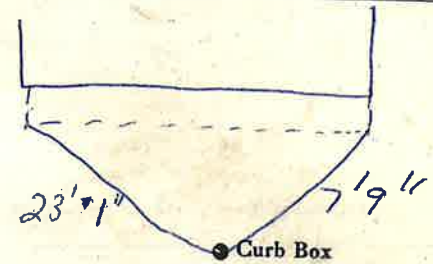

8" Main

Elev. of
Main at tap **4'**

Gate at ●

● Gate at

Think these
addresses are
razed

b Box