

LABOR AND MATERIALS

1	Copper Lead	Connection	3/4"			\$ 2.29
1	Curb	Cock Valve T.S. & V.	3/4" in.			\$ 2.70
1	Service box Old returned	Short 3 1/2 x 4 1/2 Long 4 1/2 x 5 1/2 Buff or Rdway				\$ 4.25
8	Ft.	3/4 in. Copper G.I. C.I.	Pipe at	35		\$ 2.80
	Nipples	in. at				\$
	Bushings	to in. at				\$
	Red'g Inc'g	Coupl'gs to in. at				\$
	Union	in. at				\$
	Meter	in. at				\$
	Lead Joints	at				\$
	Compound Joints	at				\$
1	Hrs. Water Maint. Man	1 at				\$ 1.12
1	Hrs. Water Maint. Man	2 at				\$ 1.02
10	Hrs. Labor	at	91			\$ 9.10
	Hrs. Labor	at				\$
	Hrs. Compressor	at				\$
	Compensation Ins.	at \$ per C.				\$ 25
	Trucking					\$ 1.
	Pav't Patch	B.P.				\$
	Tap by Marsinski					\$
	O'head					\$
						\$ 24.53

(Tap on Division) Before Taving

IX-1-1150

Grandall


St. ~~Pl.~~
Ave. No. 17

Name of Owner

Ray Mott

Labor and Mat'l. Report

Aug 23 1950

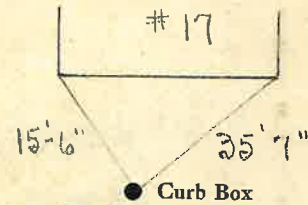

Grandall St.

Division St.

4' Main

Elev. of Main at tap 5'

Gate at ●

● Gate at

● Curb Box

Tap on Division St.

LABOR AND MATERIALS

Copper } Connection _____ \$ _____
 Lead }
 Curb } Cock } _____ in. _____ \$ _____
 } Valve }
 } T.S. & V. }
 Service box { Short 3-1/2 x 4-1/2 } _____ \$ _____
 Old returned { Long 4-1/2 x 5-1/2 }
 Ft. _____ in. { Copper } Pipe at _____ \$ _____
 } G.I. }
 } C.I. }
 Nipples _____ in. at _____ \$ _____
 Bushings _____ to _____ in. at _____ \$ _____
 Red'g _____
 Inc'g _____
 Union _____ in. at _____ \$ _____
 Meter _____ in. at _____ \$ _____
 _____ \$ _____
 Compound Joints at _____ \$ _____
 Maintenance Foreman _____ \$ _____
 Hrs. Water Maint. Man - 1 at _____ \$ _____
 Hrs. Water Maint. Man - 2 at _____ \$ _____
 Hrs. Garage Foreman _____ at _____ \$ _____
 Hrs. Labor _____ at _____ \$ _____
 Hrs. Compressor at _____ \$ _____
 _____ \$ _____
 Trucking _____ \$ _____
 Pav't Patch _____ \$ _____
 _____ \$ _____
 _____ \$ _____
 _____ \$ _____
 _____ \$ _____

CRANDALL

St. _____
 Pl. _____
 Ave. No. _____

17

Name of Owner _____

Labor and Mat'l. Report 19 _____

4-9-2001

SEWER CLEAN OUT
 INSTALLED NEXT TO H₂O
 ON DIVISION ST.

PER

Curb Box

TONY MISSITA

_____ Main

Elev. of
 Main at tap _____

Gate at

Gate at _____

Curb Box